

The Xcel logo consists of the word "Xcel" in a red, stylized, handwritten font. The letter "X" is enclosed within a light gray oval shape.

General  
Krause C  
N3897 D  
Helenville  
Toby Kra  
toby.krause@



# **GROUND AFFECTS LANDSCAPING, INC.**

The logo for Ground Affects Landscaping, Inc. features the company name in a bold, sans-serif font. The letters are partially obscured by a graphic of several evergreen trees of varying heights. Below the main name, the words "PROFESSIONAL DESIGN AND INSTALLATION" are written in a smaller, all-caps font.



 Structural  
Engineering



**FOREMOST**  
**BUILDINGS, INC.**

**Metal Building Manufacturer**  
Foremost Buildings, Inc.  
895 N Parkway Street  
Jefferson WI 53549  
Jim Horn  
[JimH@foremostbuildings.com](mailto:JimH@foremostbuildings.com)  
920-674-5028



414-573-1047



**Plumbing**  
Plumber Pipe



 
# Xcel Sports Complex

 
# Enlarged First Floor Plan (West)

---

Date 12/14/2015 4:02:43 PM

A-101.A





6 | 5 | 4 | 3 | 2 | 1 |



**er**  
60 Highwood Circle  
ddleton, Wisconsin 53562  
dd Goldbeck  
[d@xcel.net](mailto:d@xcel.net)  
3-279-6960



**General Contractor**  
Krause Custom Builders  
897 Duck Creek Rd  
Denville, WI 53137  
by Krause  
[krause@gmail.com](mailto:krause@gmail.com)  
920-285-6490




**ll**  
ake Country Engineering  
0 S. Silver Lake Street, Suite 10  
onomowoc, WI 53066  
o Davy      [rob@lce.biz](mailto:rob@lce.biz)  
(2) 569-933



**andscape**  
ound Affects Landscaping, Inc.  
526 Froelich Rd.  
livan, WI 53178  
m Ball  
[n@groundaffectslandscaping.com](mailto:n@groundaffectslandscaping.com)  
250-216-1234



**chitect**  
OpeningDesign  
2 W. Lakeside St  
Madison, WI 53715  
Dan Schultz  
[dan@openingdesign.com](mailto:dan@openingdesign.com)  
608-425-6456

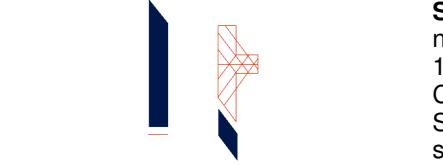

**uctural  
ve  
08 S. Ashland Ave., #82002  
icago, IL 60608**

**Structural  
Systems  
Division**  
808 S. Ashland Ave., #82002  
Chicago, IL 60608  
John Uecke  
juecke@ntrive.com  
(312) 480-4120x101



emost Buildings, Inc.  
5 N Parkway Street  
Jefferson WI 53549  
John Horn  
[JH@foremostbuildings.com](mailto:JH@foremostbuildings.com)  
920-674-5028




Lake Country Heating and Cooling  
333 Hwy F  
Pleasanton, WI 53066  
John Shuda  
[@lakecountryhvac.com  
414-573-1047](mailto:@lakecountryhvac.com)



73 S. Industrica Ave  
Jefferson, WI 53549  
Miss Davis  
[current.electric@att.net](mailto:current.electric@att.net)



0-674-6444

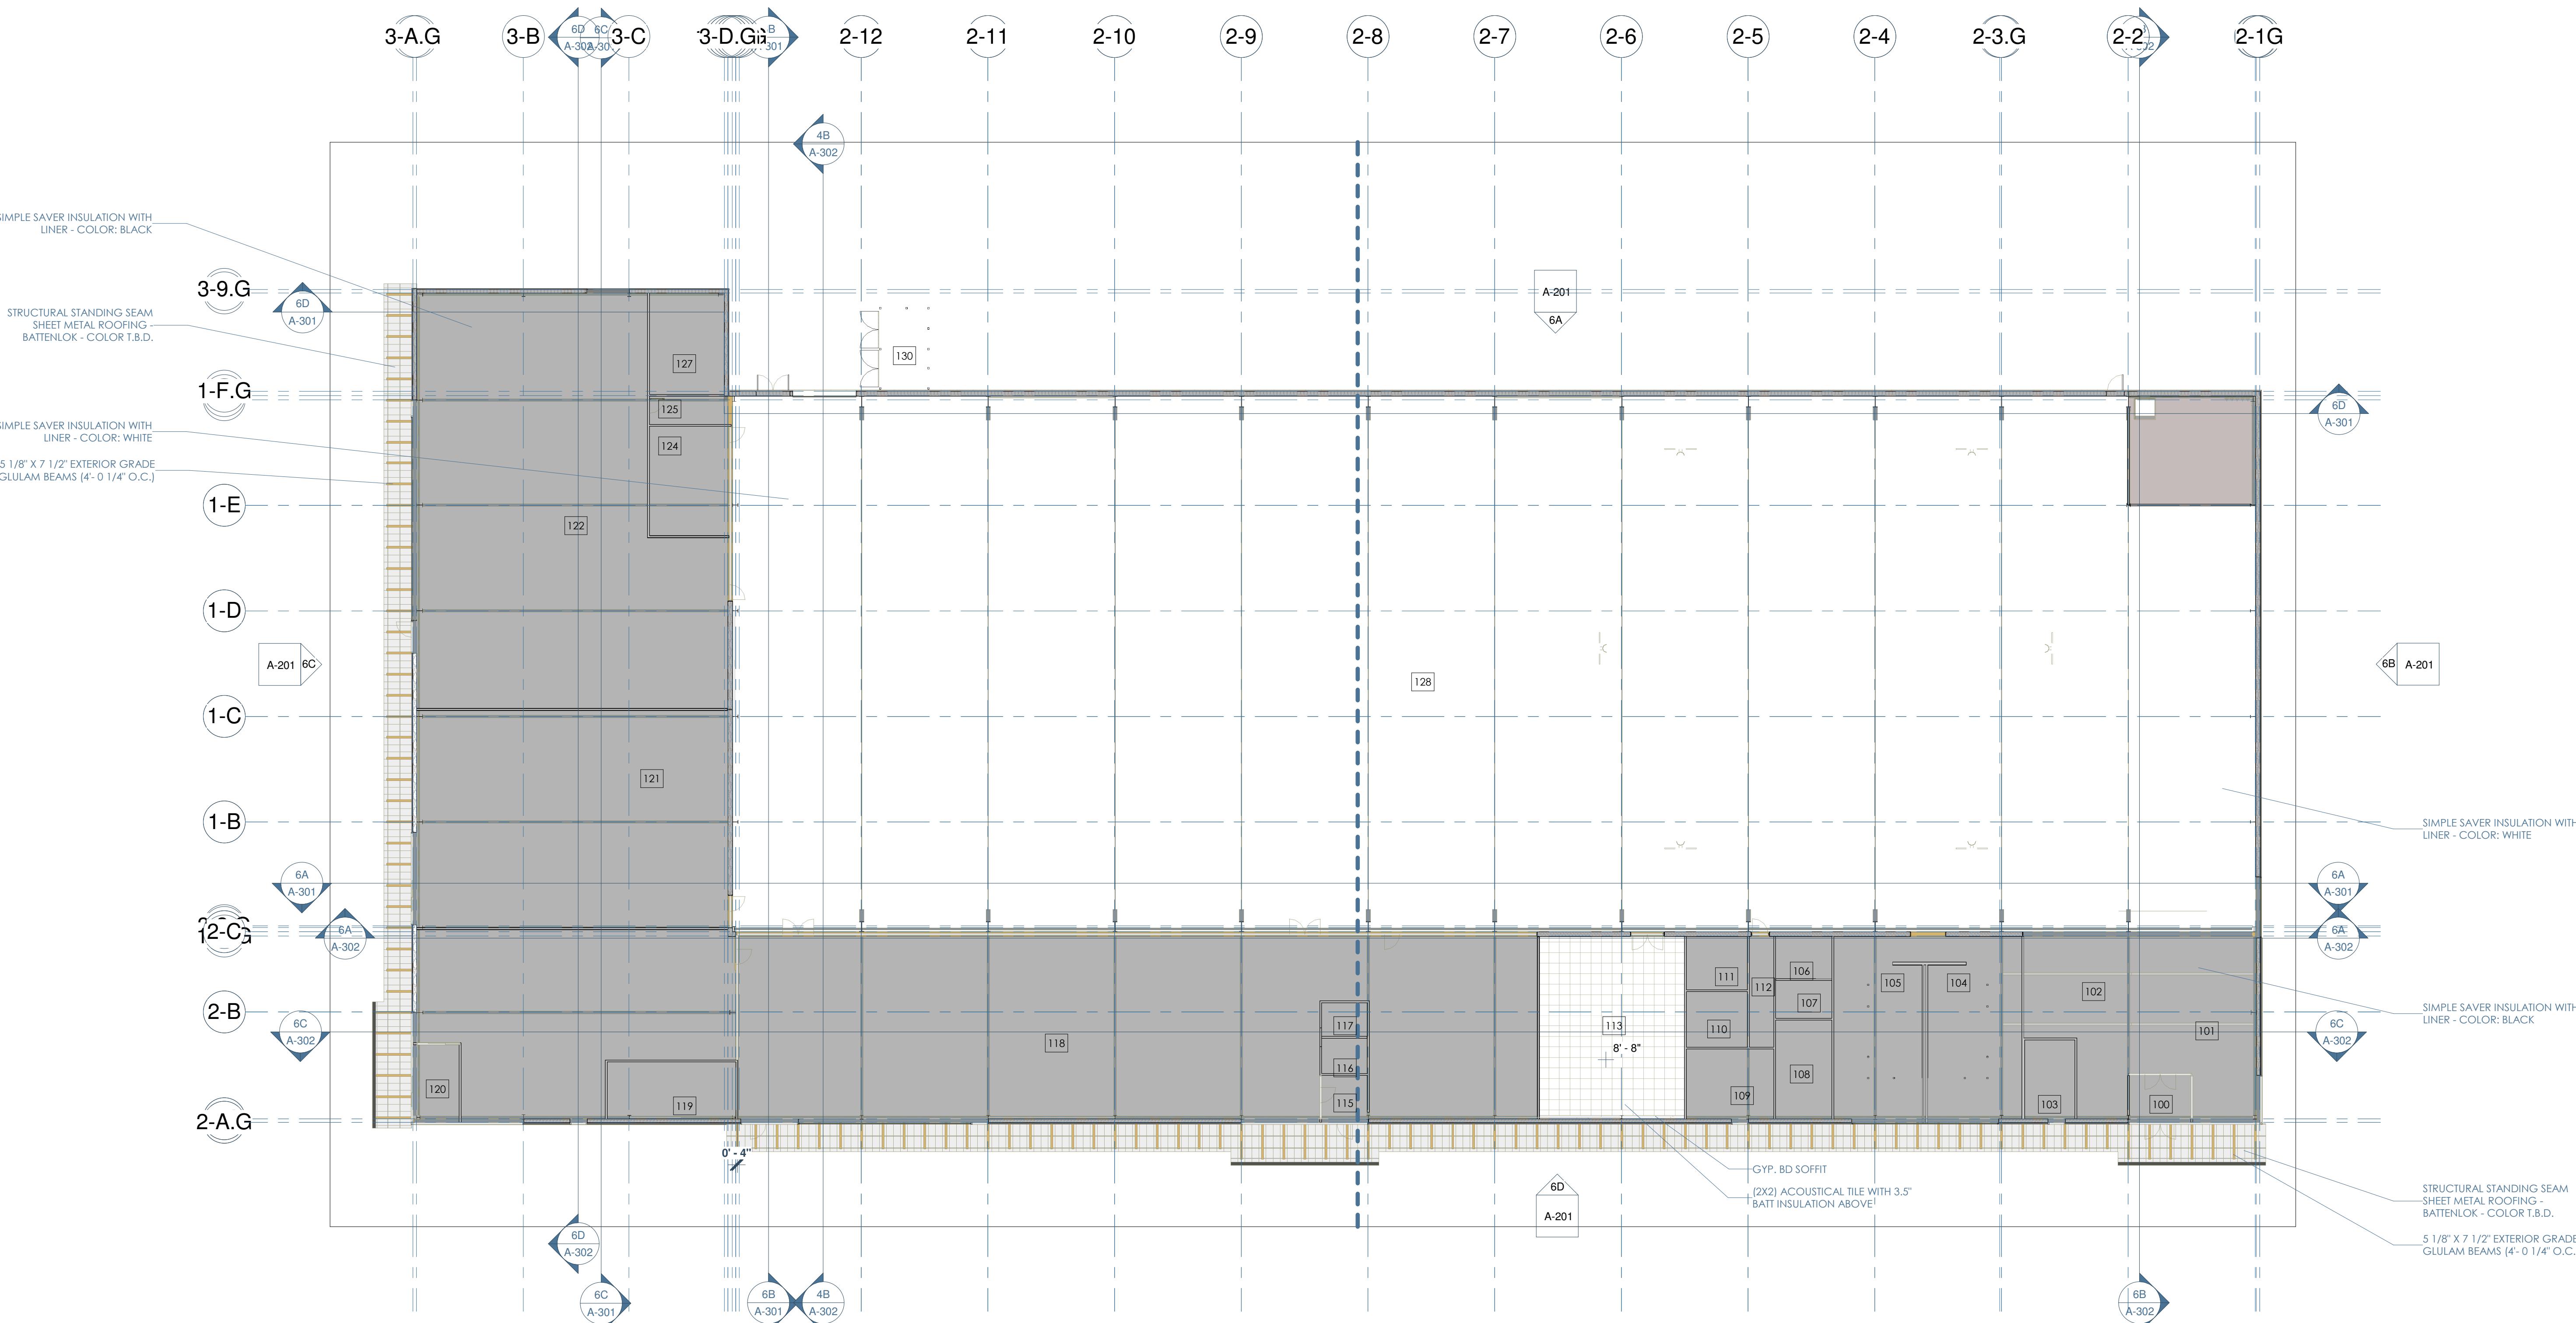

# Xcel Sports Complex


# Reflected Ceiling Plan

---


Date 12/14/2015 4:02:52 PM

---


1/16" = 1' 0"

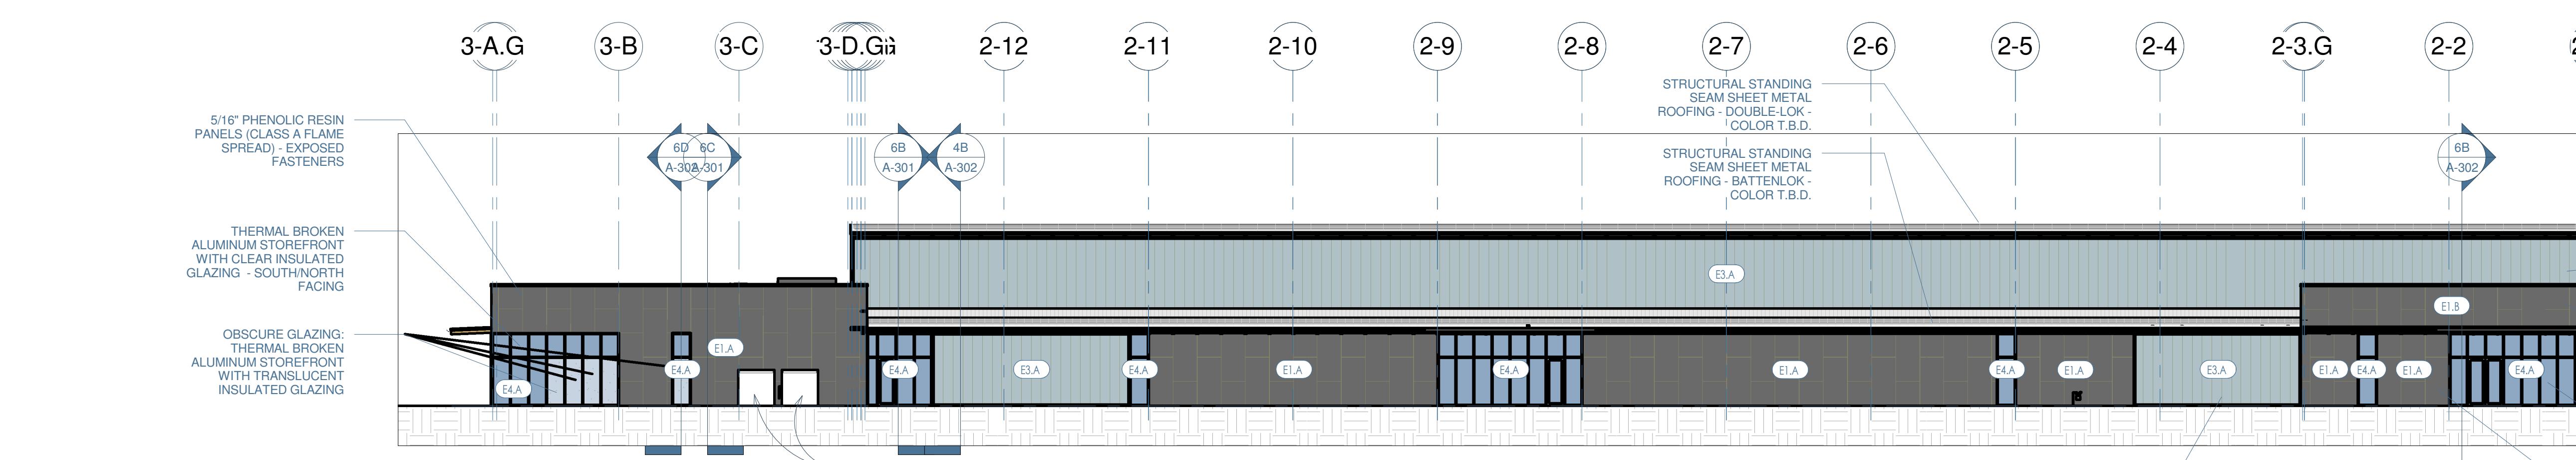


Elevation - South  
1/16" = 1'-0"

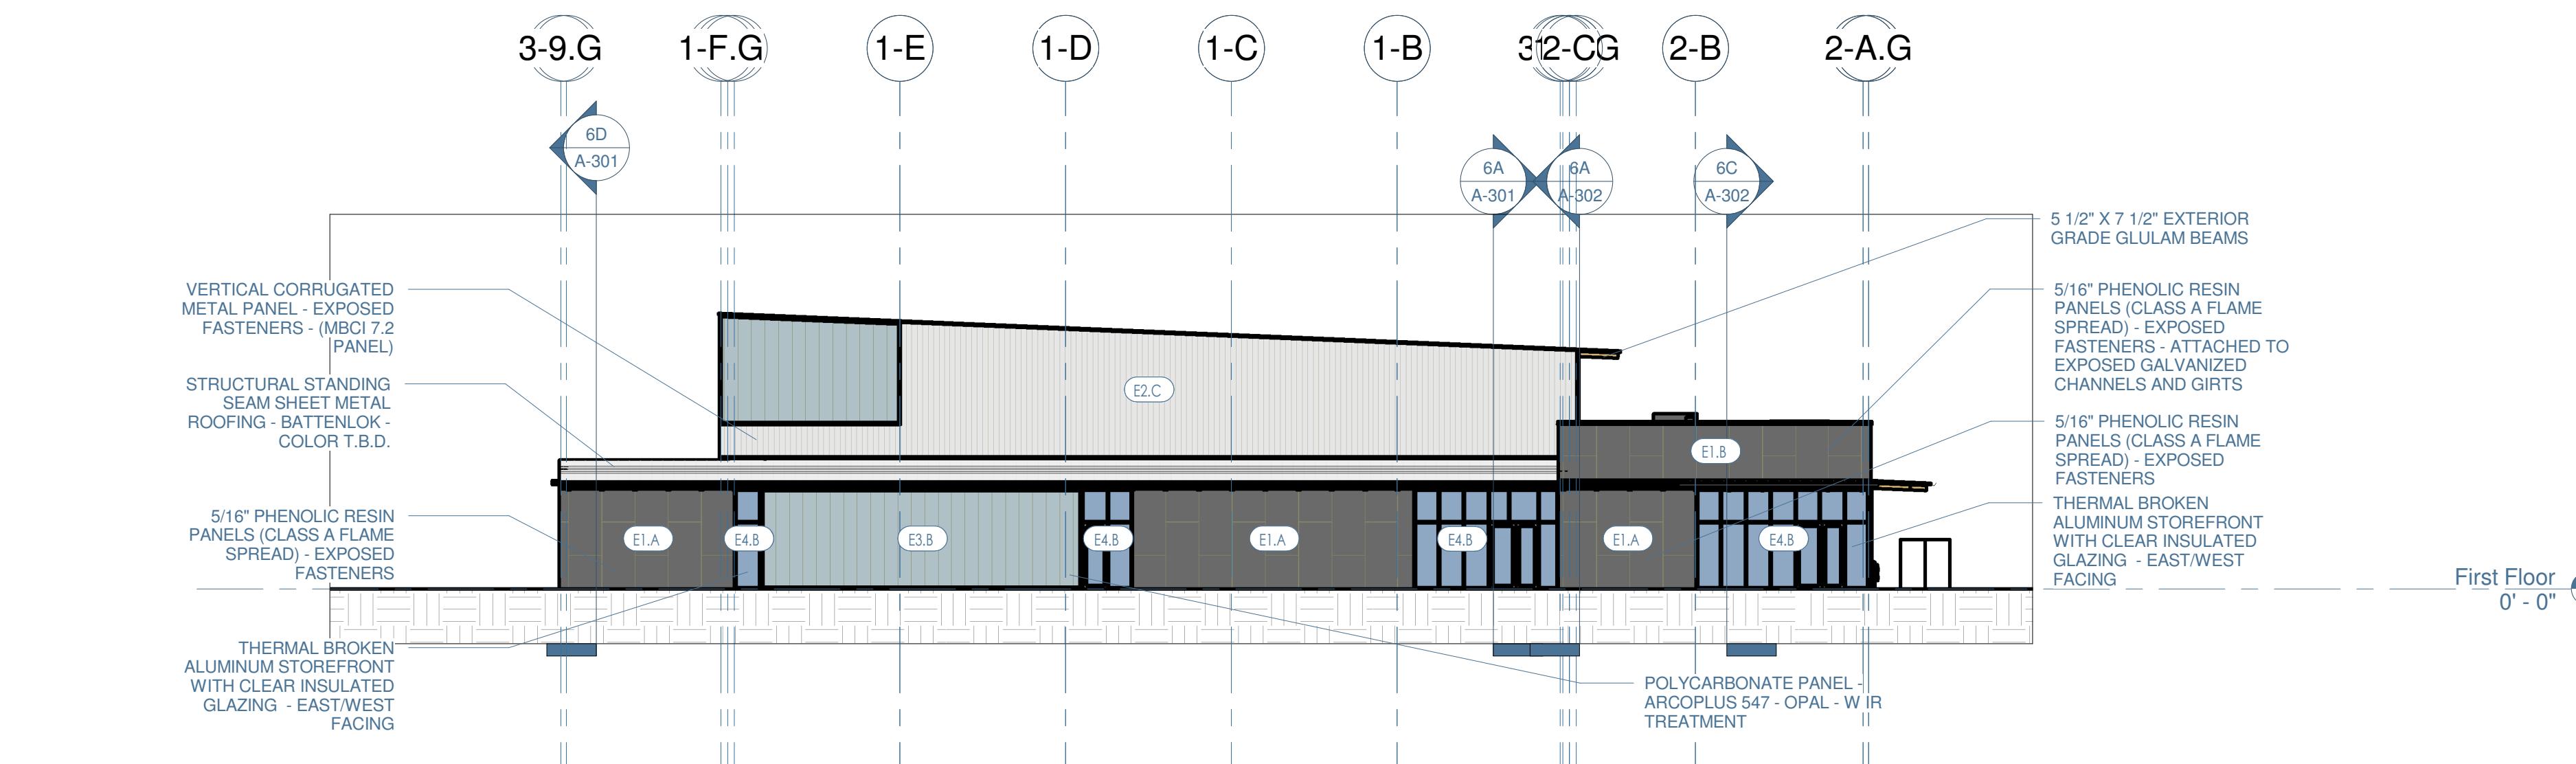

Elevation - West  
1/16" = 1'-0"

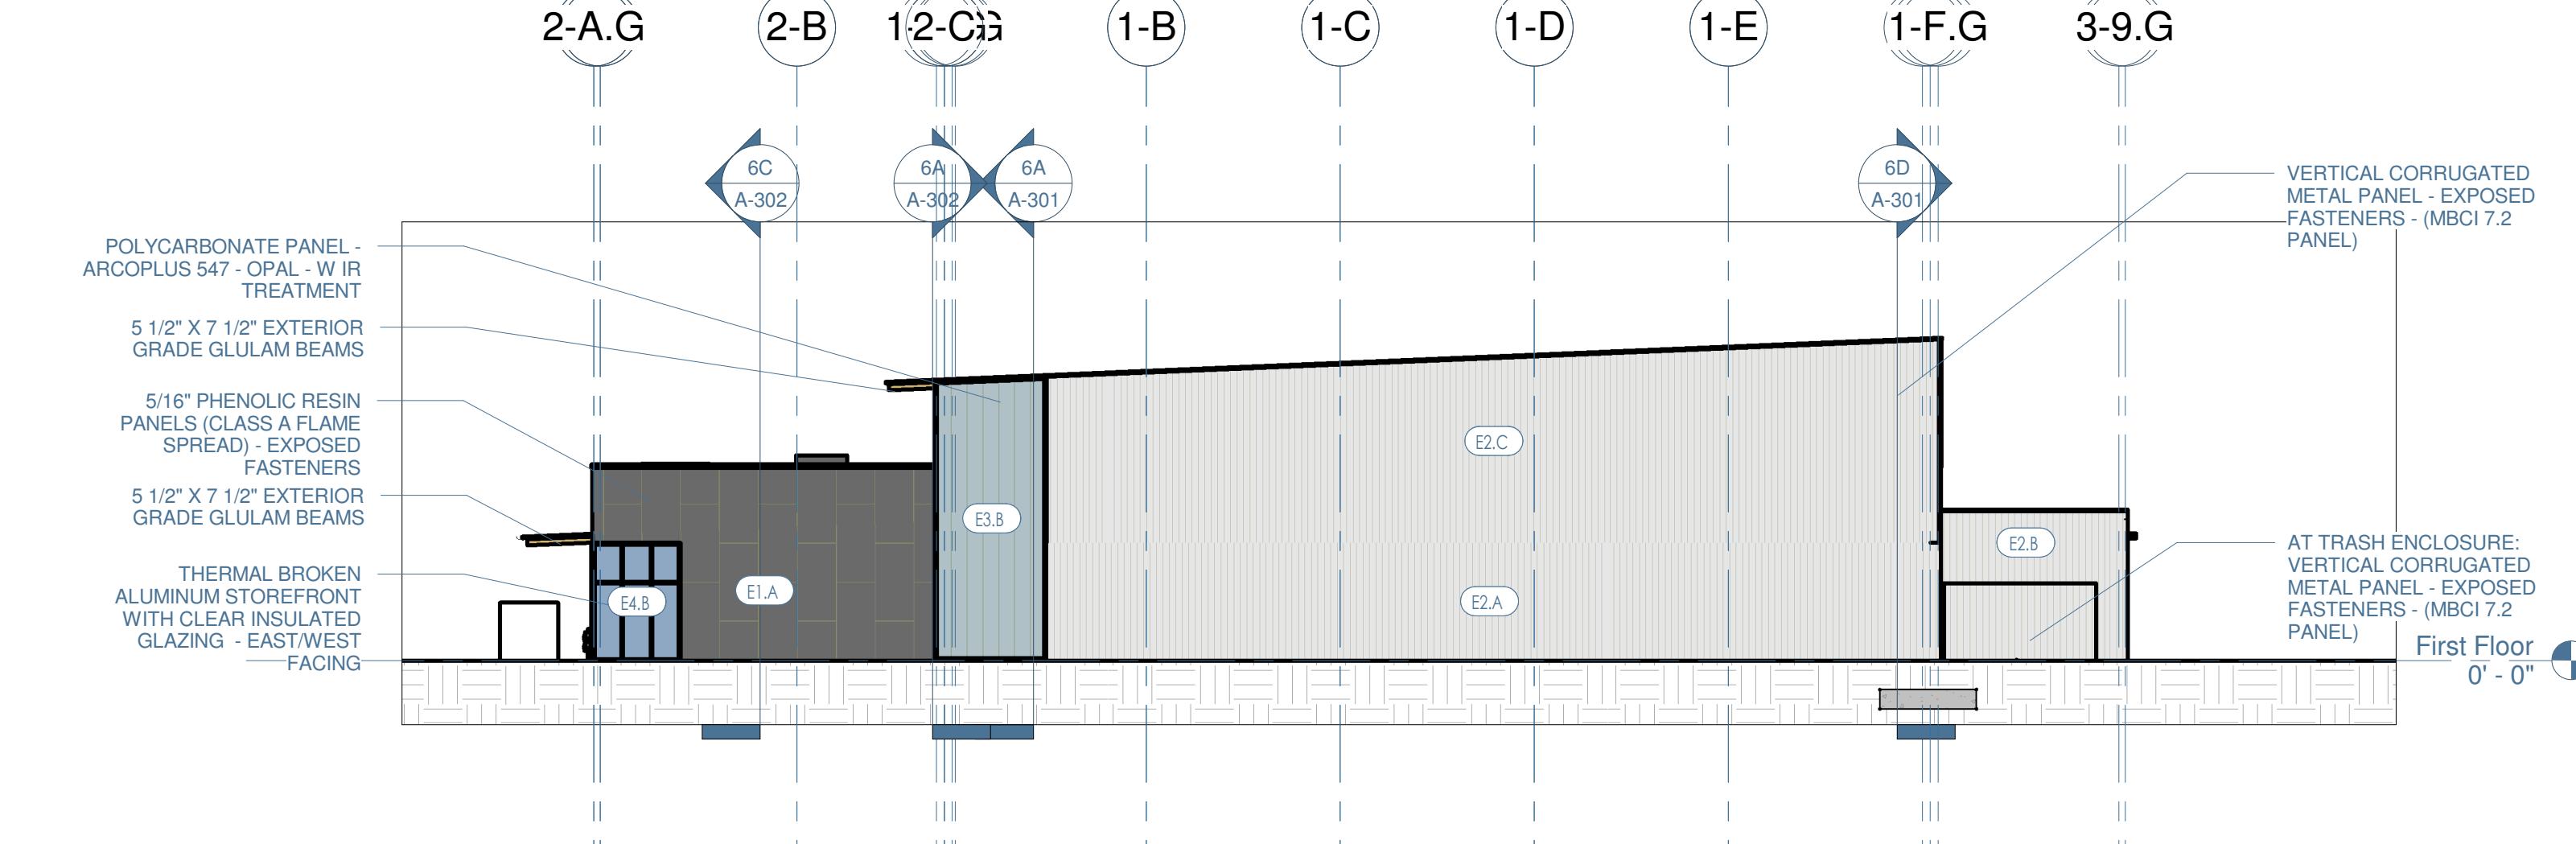

Elevation - East  
1/16" = 1'-0"

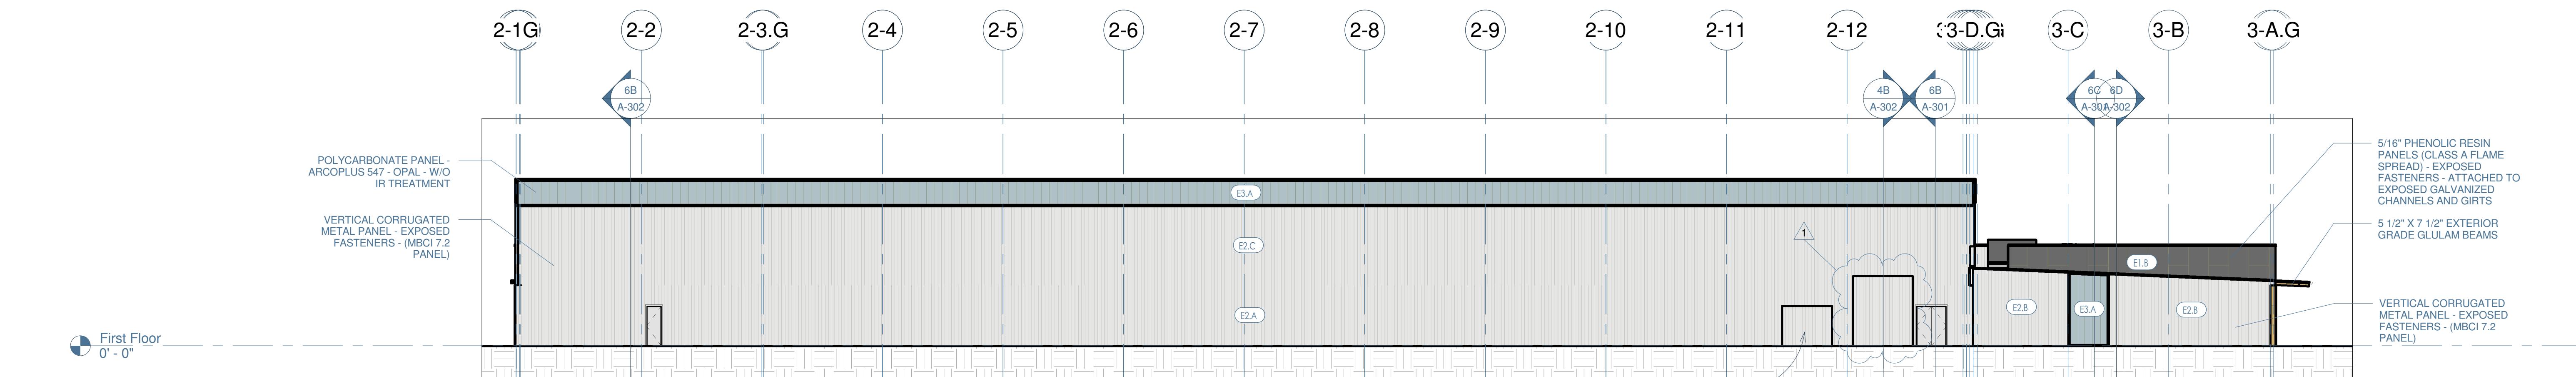

Elevation - North  
1/16" = 1'-0"

Wall Assemblies						
Wall Orientation	Type Mark	Type	Area	U-Factor	SHGC	VT
East	E1.B	5/16" THICK STONEWOOD RESIN PANELS - EXPOSED FASTENERS - ATTACHED TO EXPOSED GALVANIZED CHANNELS AND GIRTS	310 SF	0	0	0
East	E1.A	5/16" THICK STONEWOOD RESIN PANELS - EXPOSED FASTENERS	373 SF	0.055	0	0
East	E2.C	METAL WALL PANEL W/ EXPOSED INT. INSULATION - 10" GIRT	1765 SF	0.04	0	0
East	E2.B	METAL WALL PANEL WITH INT. PLYWOOD - 8" GIRT	303 SF	0.055	0	0
East	E2.A	METAL WALL PANEL WITH INT. PLYWOOD - 10" GIRT	1116 SF	0.04	0	0
East	E2.10	Metal Wall Panel with plywood extint	8 SF	0.04	0	0
East	E3.B	POLYCARBONATE PANEL - ARCOPLUS 547 - OPAL - W/ IR TREATMENT	336 SF	0.26	0.3	0.26
East	E4.B	THERMAL BROKEN ALUMINUM STOREFRONT WITH CLEAR INSULATED GLAZING - EAST/WEST FACING	113 SF	0.28	0.22	0.41
North	E2.C	METAL WALL PANEL W/ EXPOSED INT. INSULATION - 10" GIRT	4558 SF	0.04	0	0
North	E2.B	METAL WALL PANEL WITH INT. PLYWOOD - 8" GIRT	730 SF	0.055	0	0
North	E2.A	METAL WALL PANEL WITH INT. PLYWOOD - 10" GIRT	3336 SF	0.04	0	0
North	E3.B	POLYCARBONATE PANEL - ARCOPLUS 547 - OPAL - W/O IR TREATMENT	1641 SF	0.28	0.39	0.3
South	E1.A	5/16" THICK STONEWOOD RESIN PANELS - EXPOSED FASTENERS	2517 SF	0.055	0	0
South	E1.B	5/16" THICK STONEWOOD RESIN PANELS - EXPOSED FASTENERS - ATTACHED TO EXPOSED GALVANIZED CHANNELS AND GIRTS	347 SF	0	0	0
South	E2.10	Metal Wall Panel with plywood extint	448 SF	0.04	0	0
South	E3.A	POLYCARBONATE PANEL - ARCOPLUS 547 - OPAL - W/O IR TREATMENT	4273 SF	0.28	0.39	0.3
South	E4.A	THERMAL BROKEN ALUMINUM STOREFRONT WITH CLEAR INSULATED GLAZING - SOUTH/NORTH FACING	1146 SF	0.38	0.34	0.62
West	E1.A	5/16" THICK STONEWOOD RESIN PANELS - EXPOSED FASTENERS	321 SF	0.055	0	0
West	E1.B	5/16" THICK STONEWOOD RESIN PANELS - EXPOSED FASTENERS - ATTACHED TO EXPOSED GALVANIZED CHANNELS AND GIRTS	448 SF	0	0	0
West	E1.A	5/16" THICK STONEWOOD RESIN PANELS - EXPOSED FASTENERS - NO INTERIOR PLYWOOD	616 SF	0.055	0	0
West	E2.C	METAL WALL PANEL W/ EXPOSED INT. INSULATION - 10" GIRT	1283 SF	0.04	0	0
West	E3.B	POLYCARBONATE PANEL - ARCOPLUS 547 - OPAL - W/ IR TREATMENT	753 SF	0.26	0.3	0.26
West	E4.B	THERMAL BROKEN ALUMINUM STOREFRONT WITH CLEAR INSULATED GLAZING - EAST/WEST FACING	579 SF	0.28	0.22	0.41

## Xcel Sports Complex

### Elevations - Exterior

Date 12/14/2015 4:03:01 PM

A-201

Scale 1/16" = 1'-0"

Owner 4860 Highway Circle  
Middleton, Wisconsin 53562  
Todd Krause todd@krause.net  
608-279-6960

**Xcel**

KRAUSE CUSTOM BUILDERS

LCE

GROUND EFFECTS LANDSCAPING, INC.

opening design

STRUCTURAL INTRIVE

FOREMOST BUILDINGS, INC.

HVAC LAKE COUNTRY HEATING AND COOLING

Electrical JEFFERSON CURRENT ELECTRIC

Plumbing PELIKAN PLUMBING

SITE PLAN REVIEW 05.13.2015

PERMIT 08.18.2015

IFC - OVERALL BUILDING 10.26.2015

1 RTU RELOCATION 11.02.2015



Highwood Circle  
Eaton, Wisconsin 53562  
Goldbeck  
[excel.net](http://excel.net)  
9-6960



**al Contractor**  
Custom Builders  
Duck Creek Rd  
ille, WI 53137  
rause  
[rause@gmail.com](mailto:rause@gmail.com)  
5-6490



country Engineering  
Silver Lake Street, Suite 10  
mowoc, WI 53066  
avy robdb@lce.biz  
69-933



**cape**  
d Affects Landscaping, Inc.  
5 Froelich Rd.  
n, WI 53178  
all  
[roundaffectslandscaping.com](http://roundaffectslandscaping.com)  
800-622-1000



**ect**  
ngDesign  
1 Lakeside St  
n, WI 53715"  
Schultz  
[openingdesign.com](http://openingdesign.com)  
5-6456



5. Ashland Ave., #82002  
o, IL 60608  
Uecke  
[e@ntrive.com](mailto:e@ntrive.com)  
0-4120x101



**Building Manufacturer**  
Most Buildings, Inc.  
100 Parkway Street  
Milwaukee WI 53549  
800-555-2345  
[foremostbuildings.com](http://foremostbuildings.com)



Country Heating and Cooling  
Hwy F  
Mowoc, WI 53066  
uda



**cal**  
on Current Electric  
5. Industrica Ave



4-6444

# Xcel Sports Complex

# Building Sections

12/14/2015 4:03:06

A-301

1/16" = 1'-0"



ghwood Circle  
n, Wisconsin 53562  
ldbeck  
cel.net  
-6960



**Contractor**  
Custom Builders  
Duck Creek Rd  
e, WI 53137  
ause  
[use@gmail.com](mailto:use@gmail.com)  
-6490



Country Engineering  
Silver Lake Street, Suite 105  
Owoc, WI 53066  
rob@lce.biz



**ape**  
Affects Landscaping, Inc.  
Froelich Rd.  
WI 53178  
|  
[affectalandscaping.com](http://affectalandscaping.com)



**st  
Design  
Lakeside St  
, WI 53715"  
hultz  
[openingdesign.com](http://openingdesign.com)  
-6456**



Ashland Ave., #82002



**Building Manufacturer**  
First Buildings, Inc.  
Parkway Street  
Menomonie WI 53549  
[www.firstbuildings.com](http://www.firstbuildings.com)  
5028



Country Heating and Cooling  
Ivy F  
Owoc, WI 53066  
ada  
[ecountryhvac.com](http://countryhvac.com)



al  
n Current Electric



avis  
electric@att.net  
-6444

# Xcel Sports Complex

# Building Sections

---

12/14/2015 4:03:11 PM

A-302

---

$$1/16'' = 1'-0''$$