Storefront Glazing - Type (A)
Condition: South facing
Product: Tubelite 14000 Series
Glazing Color: Clear
- U- Factor: .38
- SHGC: .34
- VT: .62

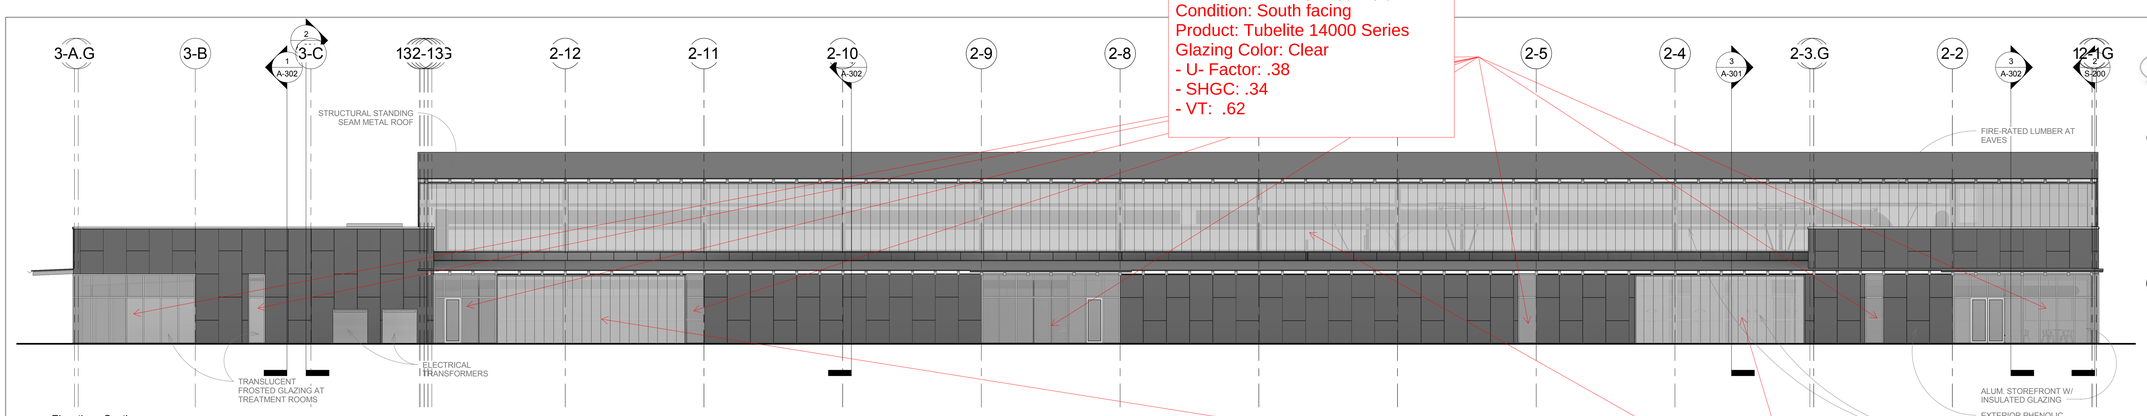

2 Elevation - South
3/32" = 1'-0"

Polycarbonate - Type (A)
Condition: South and North facing
Product: arcoPlus®547
Color: Opal
- U- Factor: .28
- SHGC: .39
- VT: .30

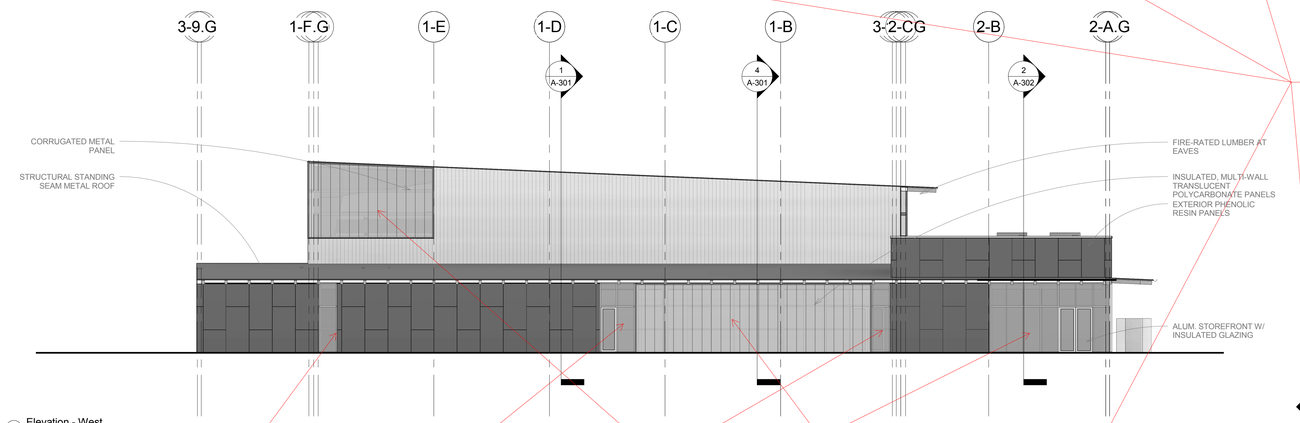

1 Elevation - West
3/32" = 1'-0"

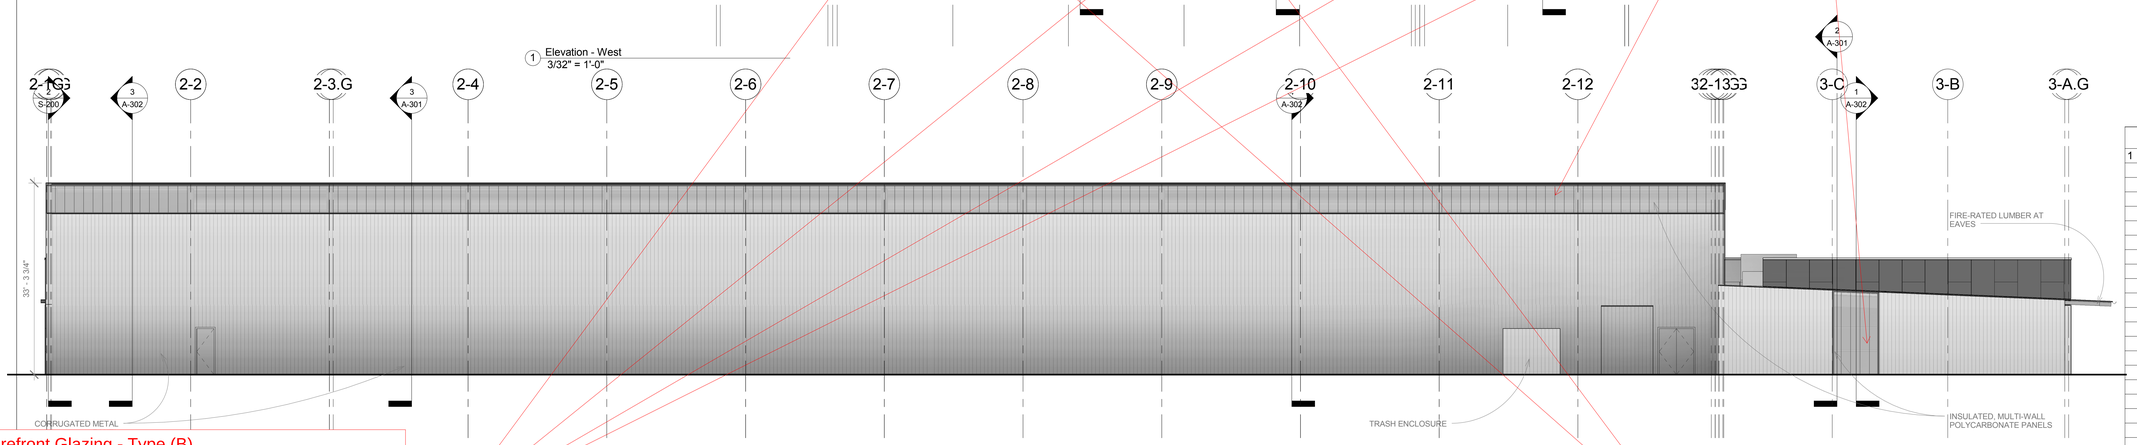

Storefront Glazing - Type (B)
Condition: East/West Facing
Product: Tubelite 14000 Series
Glazing Color: Clear
- U- Factor: .28
- SHGC: .22
- VT: .41

Polycarbonate - Type (B)
Condition: East/West Facing
Product: arcoPlus®547 w/ IR blocking
Color: Opal
- U- Factor: .26
- SHGC: .30
- VT: .26

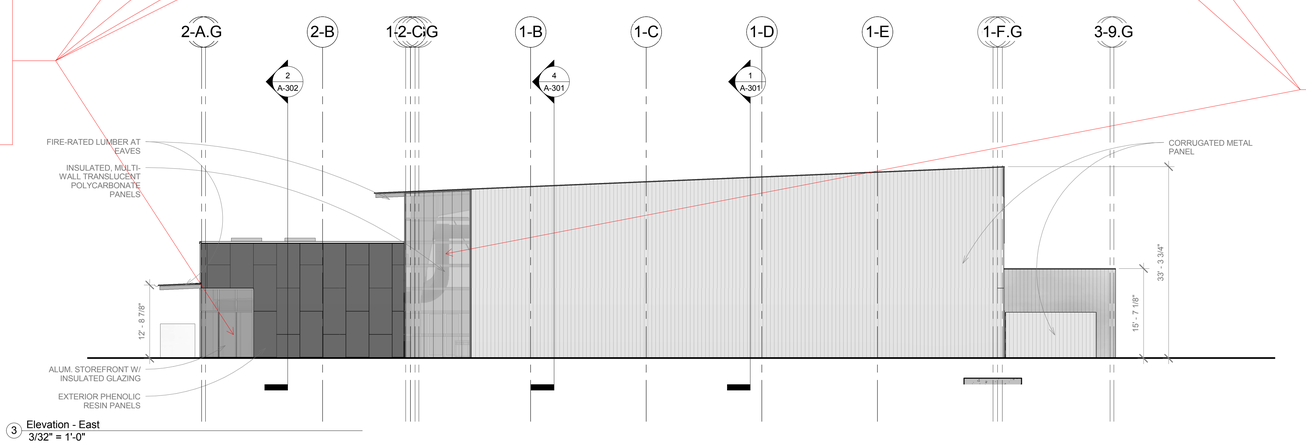

3 Elevation - East
3/32" = 1'-0"

Owner
4880 Highwood Circle
Middleton, Wisconsin 53562
Todd Goldbeck
todd@xcel.net
608-279-6960

General Contractor
Krause Custom Builders
N3897 Duck Creek Rd
Helenville, WI 53137
Toby Krause
tobykrause@gmail.com
920-285-6490

Civil
Lake Country Engineering
970 S. Silver Lake Street, Suite 105
Oconomowoc, WI 53066
Rob Davy robd@lce.biz
(262) 569-933

Landscape
Ground Affects Landscaping, Inc.
W1526 Froelich Rd.
Sullivan, WI 53178
Tom Ball
tom@groundaffectslandscaping.com
262.593.8400

Architect
OpeningDesign
312 W. Lakeside St
Madison, WI 53715*
Ryan Schultz
ryan@openingdesign.com
773-425-6456

Structural
ntrive
1608 S. Ashland Ave., #82002
Chicago, IL 60608
Steven Uecke
s.uecke@ntrive.com
630-480-4120x101

Metal Building Manufacturer
Foremost Buildings, Inc.
895 N Parkway Street
Jefferson WI 53549
Jim Horn
JimH@foremostbuildings.com
920-674-5028

HVAC
Lake Country Heating and Cooling
N6333 Hwy F
Oconomowoc, WI 53066
Jim Shuda
jim@lakecountryhvac.com
414-573-1047

Electrical
Jefferson Current Electric
1473 S. Industrica Ave
Jefferson, WI 53549
Ross Davis
j.current.electric@att.net
920-674-6444

Plumbing
Pelikan Plumbing
144 Main St
Sullivan, WI 53178
Mike Pelikan
pelikanplumbing@yahoo.com
262-593-2290

WISCONSIN RYAN P. SCHULTZ A-11197-S STOUGHTON WI ARCHITECT

No.	Description	Date
1	Site Plan Review	05.13.2015

Xcel Sports Complex

Elevations - Exterior

Date 06/15/2015

A-201

Scale 3/32" = 1'-0"

NOT FOR CONSTRUCTION

6/15/2015 4:32:29 PM